



Wes Bieber, R.P.F.

Longfellows

Natural Resource Management Solutions Inc.

MAR 10 2023
RECEIVED.

4840 16th St. NE,
Salmon Arm, B.C.
V1E 1E1
250-674-1199
wes.bieber@longfellows.ca

March 03, 2023

District of Barriere
2219-4936 Barriere Town Rd.
Barriere B.C.
V0E 1E0

Re: Removal of Private Land from Woodlot License 1596 (Barriere)

Dear Sir/Madam:

Please be advised that Carman Smith is proposing to remove 146.7 ha of Private Land from Woodlot License W1596. Attached is a map that illustrates the location of the current Schedule A Land.

Please provide any comments or concerns with this proposal in written format to Wes Bieber at the contact information noted in the letterhead by May 5, 2023.


Sincerely,



Wes Bieber, R.P.F.
Longfellows Natural Resource Management Solutions Inc.

Attachment: Woodlot Management Plan Map indicating Schedule A Land of Woodlot 1596



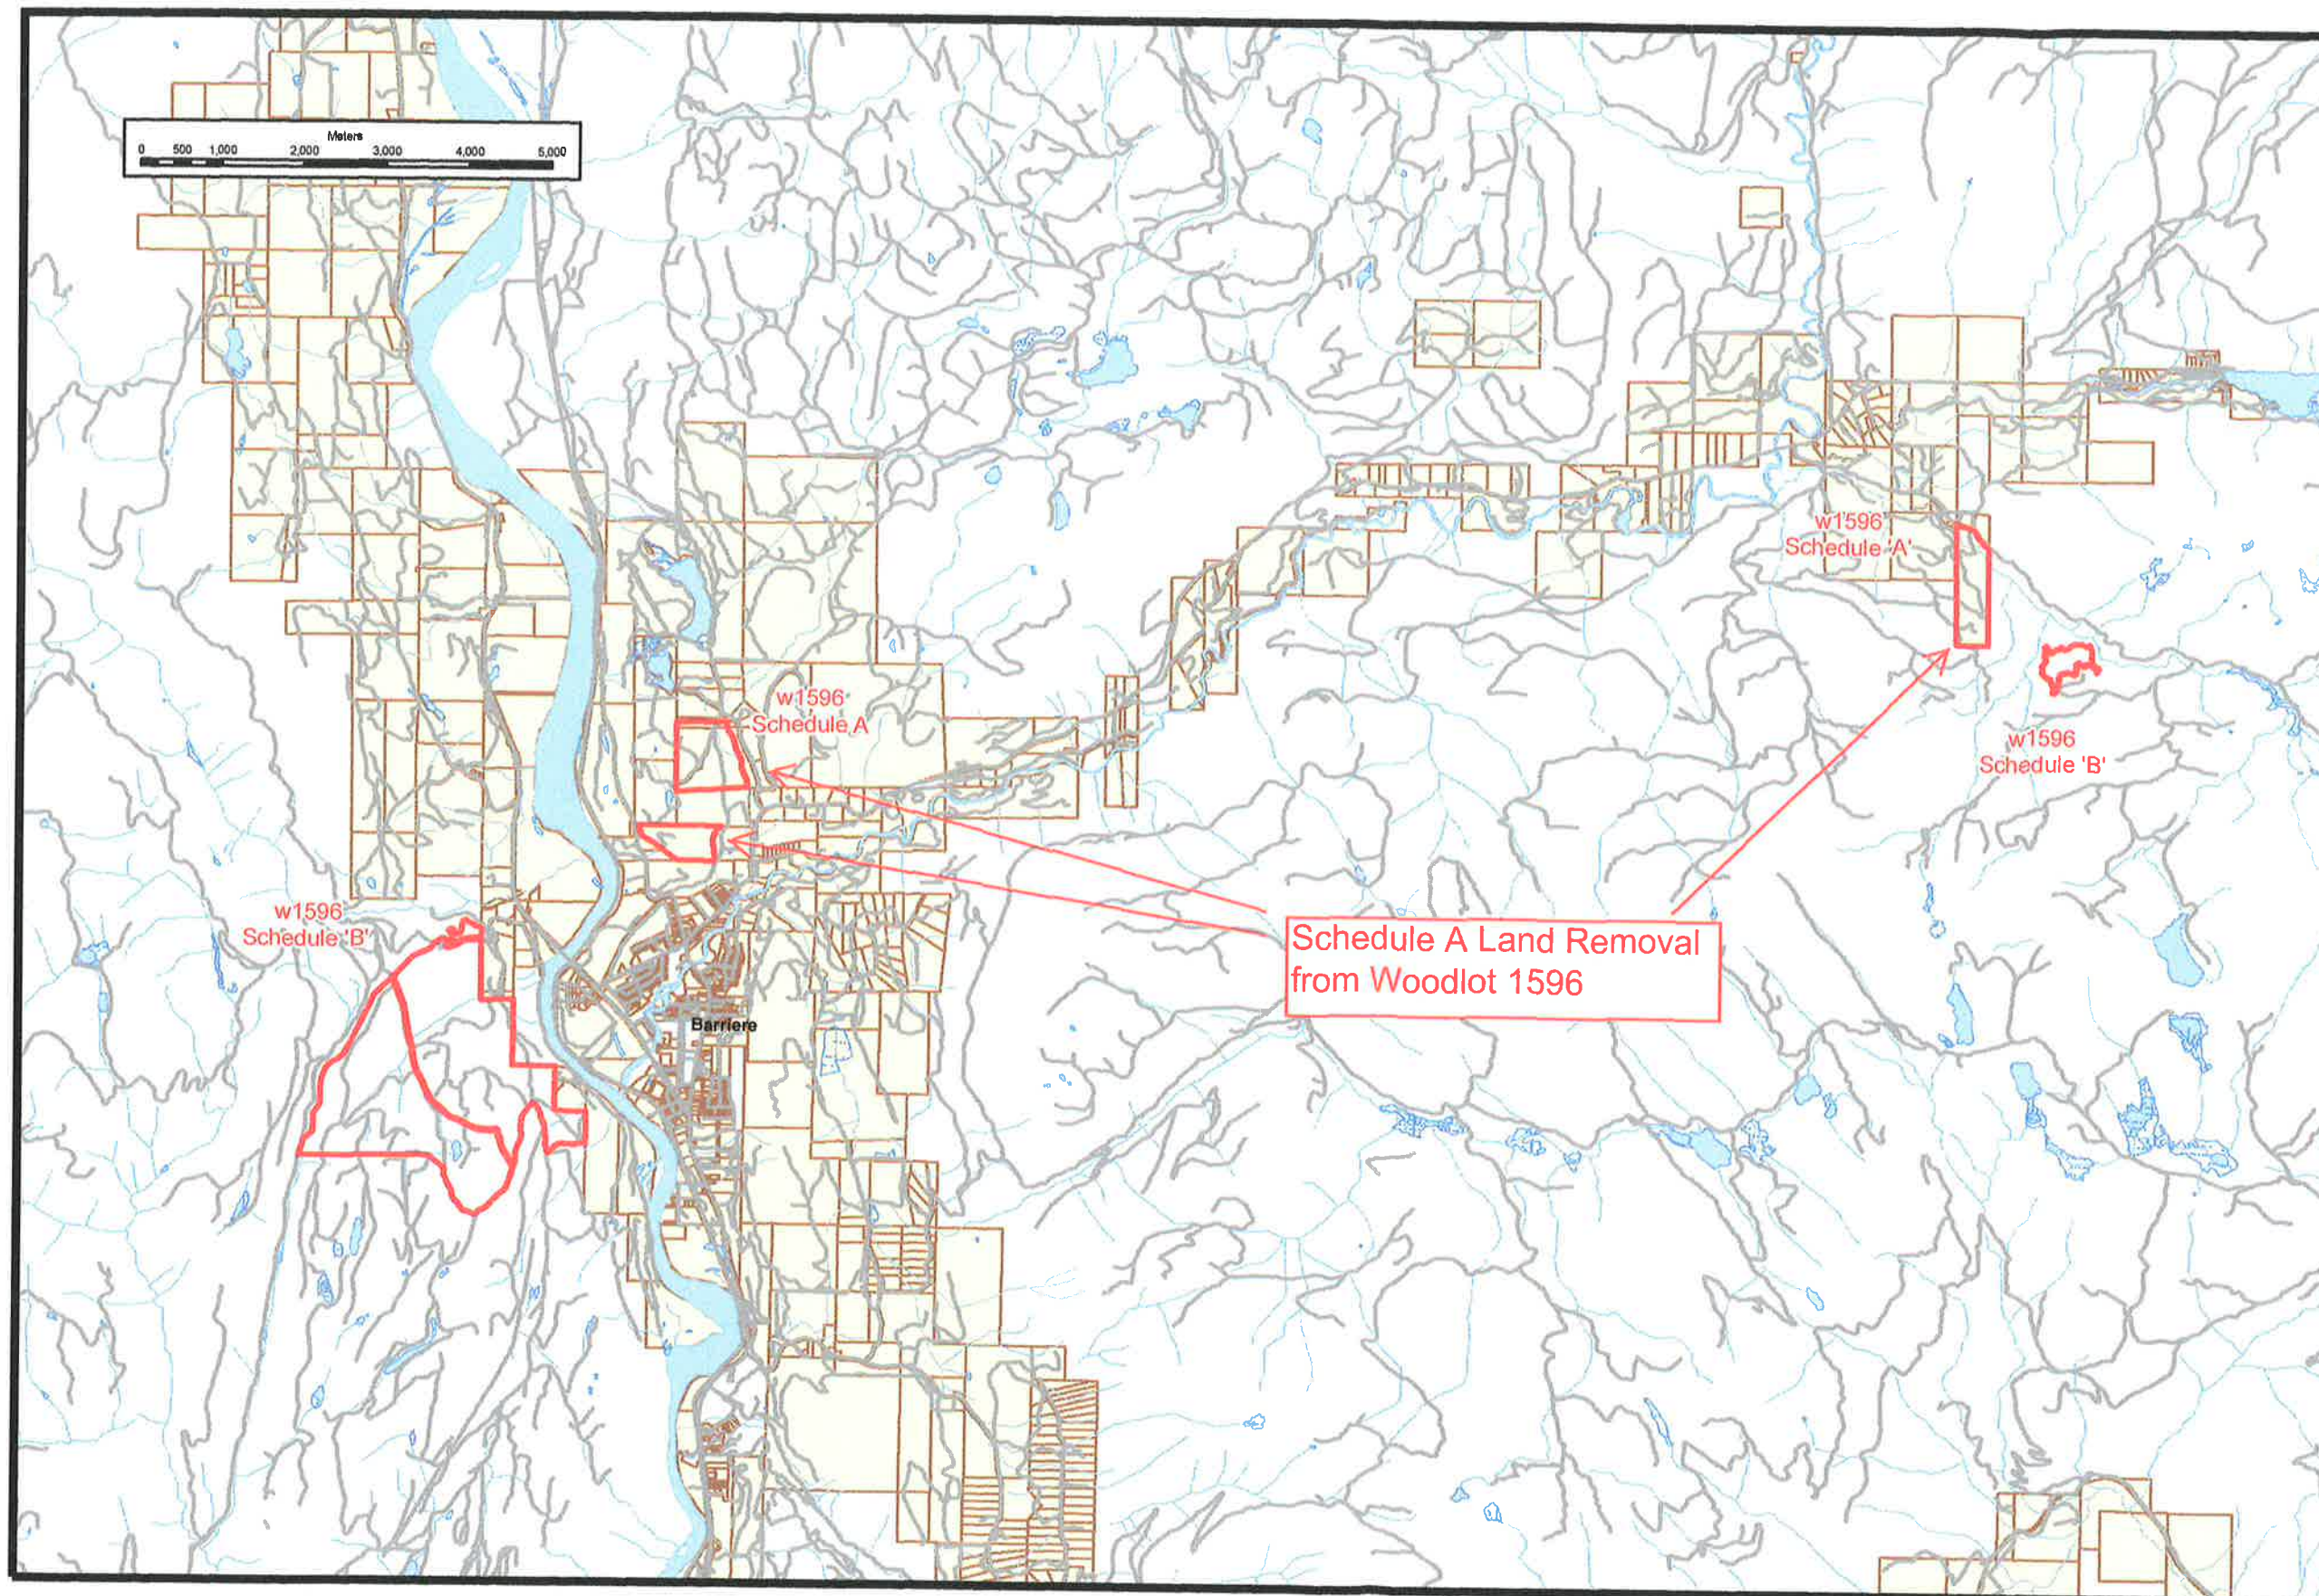

W1596 - WOODLOT MANAGEMENT PLAN Schedule A & B Lands Location Map

FOREST REGION: SOUTHERN INTERIOR
FOREST DISTRICT: KAMLOOPS
T.S.A.: KAMLOOPS
PSYU: NEHALLISTON P.H.A #2
INVENTORY REGION: 57
INVENTORY COMPARTMENT: 2
FOREST INVENTORY ZONE: G
2008 DECLINATION: 17° 40' E
PLOT FILE: W1596-WMP_3-4.PDF
PLOT DATE: FEBRUARY 27, 2009
MAPSHEET: 82M021



BY: D. Wallis
P: 250-674-4082 F: 250-674-4093
E: admin@thompsonresource.com

ORIGINAL SCALE 1:100000

CARTOGRAPHIC LEGEND

- Existing
- Proposed
- Temporary
- Existing Trails
- Proposed Trail
- Forest Cover
- Cadastral
- Index
- Intermediate
- Transmission
- Pipeline
- Water Licence - PoD
- Streams - S1-S5 (Fish Bearing)
- Streams - S5-S6, NCD
- Watershed Boundary
- Water Body / River
- Wetlands
- Woodlot Boundary
- Managed Licences
- Block Boundary
- WTP
- Cadastral / Private
- Landscape Unit
- Deer
- Moose
- BEC Zone
- VQO
- OGMA
- Terrain Stability (>60%)
- Parks / PAS